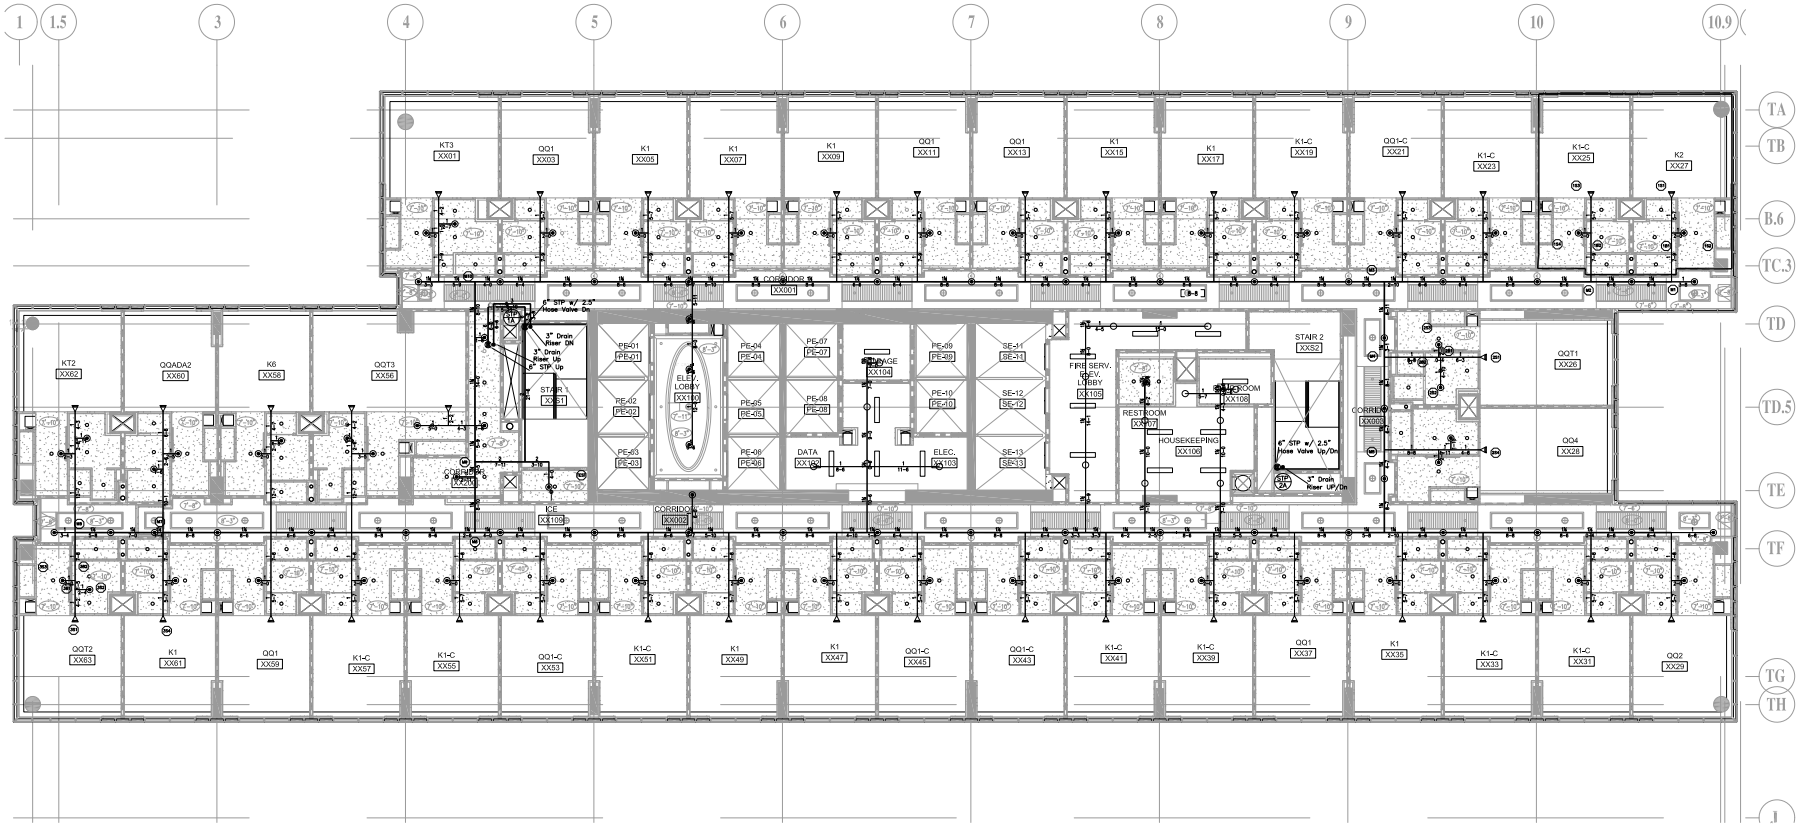

PLAN NOTES:

* ALL CEILINGS TO BE 9'-0" AFF UNLESS NOTED OTHERWISE

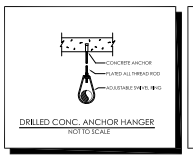

DRILLED CONC. ANCHOR HANGER
NOT TO SCALE

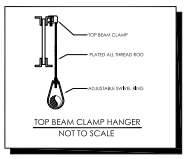

TOP BEAM CLAMP HANGER
NOT TO SCALE

LEVEL 8 - 22

Scale: 1/8" = 1'-0"

GENERAL NOTES

1. All pipe locations to be field measured prior to installation.
2. All dimensions shown are center to center.
3. High temp heads to be field located where required.
4. All pipes and hangers to be installed per NFPA 13.
5. Hangers to be U.L. Listed and F.M. Approved.
6. All materials and methods of installation to conform to State of Texas and NFPA 13 requirements.
7. All dry pipe system mains to be sloped 1/4" per 10'
8. All dry pipe system branch lines to be sloped 1/2" per 10'

Symbols

Symbol	Description
	Hydraulic Reference Points
[X]	Elev. Below Top of Steel
[F-#]	Elev. Above Finished Floor
(TOS #-#)	Elev. of Top of Steel
CH	Ceiling Height
	Denotes Hanger Location
	Rise up or down

AS-BUILT SUBMITTAL OTHER

Sprinkler Legend:

Key	Body	Description	Finish	Temp	Orifice	Model	Manufacturer
	360°	Standard Concealed Pendent	Chrome	155°	1/2"	TY3251	Tyco
	360°	Standard Concealed Pendent	White	155°	1/2"	TY3251	Tyco
	360°	Standard Recessed Pendent	Chrome	155°	1/2"	TY3151	Tyco
	360°	Standard Recessed Pendent	White	155°	1/2"	TY3151	Tyco
	360°	Standard Upright Pendent	Brass	155°	1/2"	TY3131	Tyco
	360°	Standard Upright Pendent	Chrome	155°	1/2"	TY3131	Tyco
	360°	Standard Upright Pendent	White	155°	1/2"	TY3131	Tyco
	360°	Standard Sidewall Pendent	Chrome	155°	1/2"	TY3231	Tyco
	360°	Standard Sidewall Pendent	White	155°	1/2"	TY3231	Tyco

Drawing title: LEVEL 8 - 22
Project:
Date:
Scale:
Drawn:
Check:
Approved:

SHEET FP - 12.0